


United States Department of the Interior
National Park Service

National Register of Historic Places
Continuation Sheet

Section number 10 Page 22

GEOGRAPHIC DATA

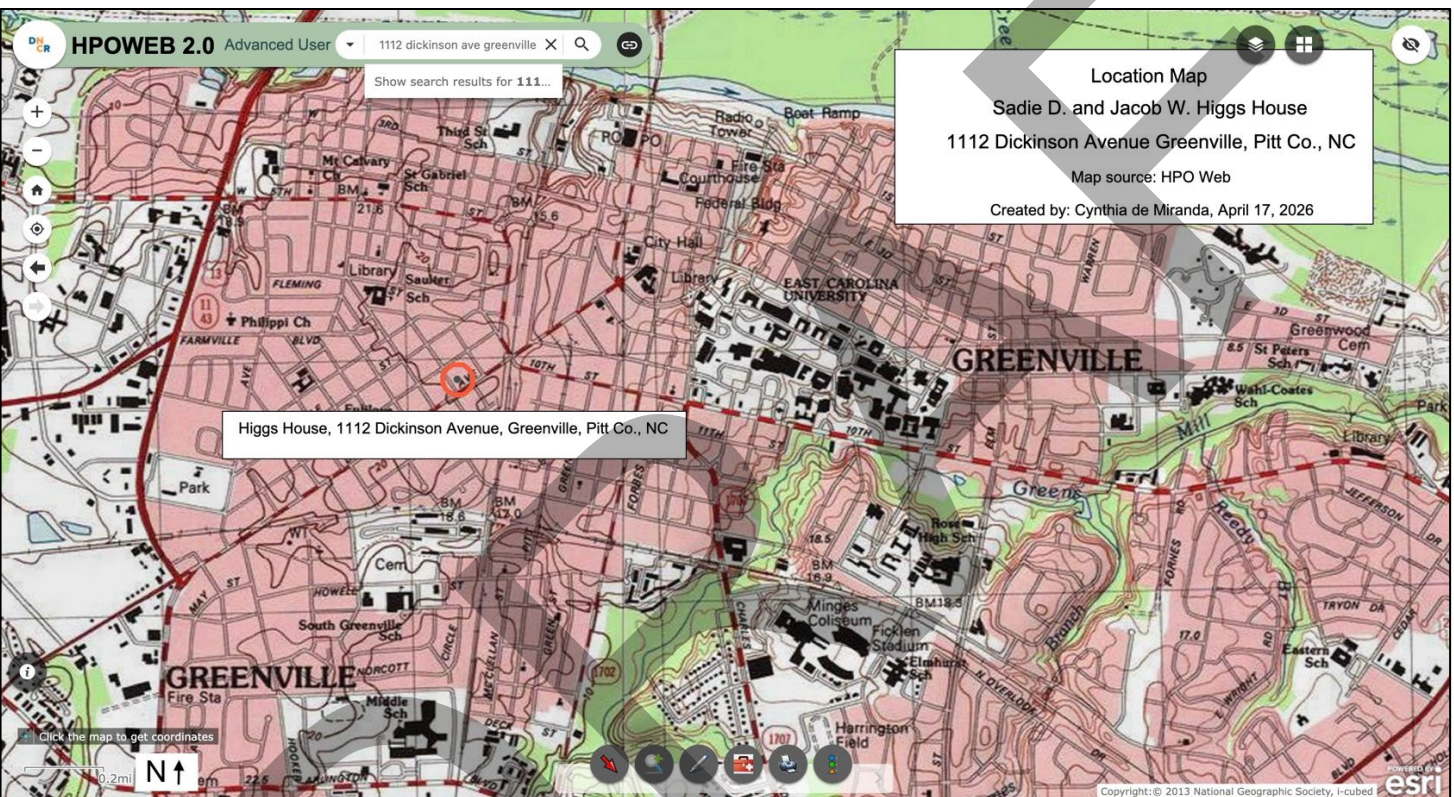


Higgs, Sadie D. and Jacob W., House
Name of Property
Pitt County, NC
County and State
Name of multiple listing (if applicable)

United States Department of the Interior
National Park Service

National Register of Historic Places
Continuation Sheet

Section number 10 Page 23

Higgs, Sadie D. and Jacob W., House
Name of Property
Pitt County, NC
County and State
Name of multiple listing (if applicable)

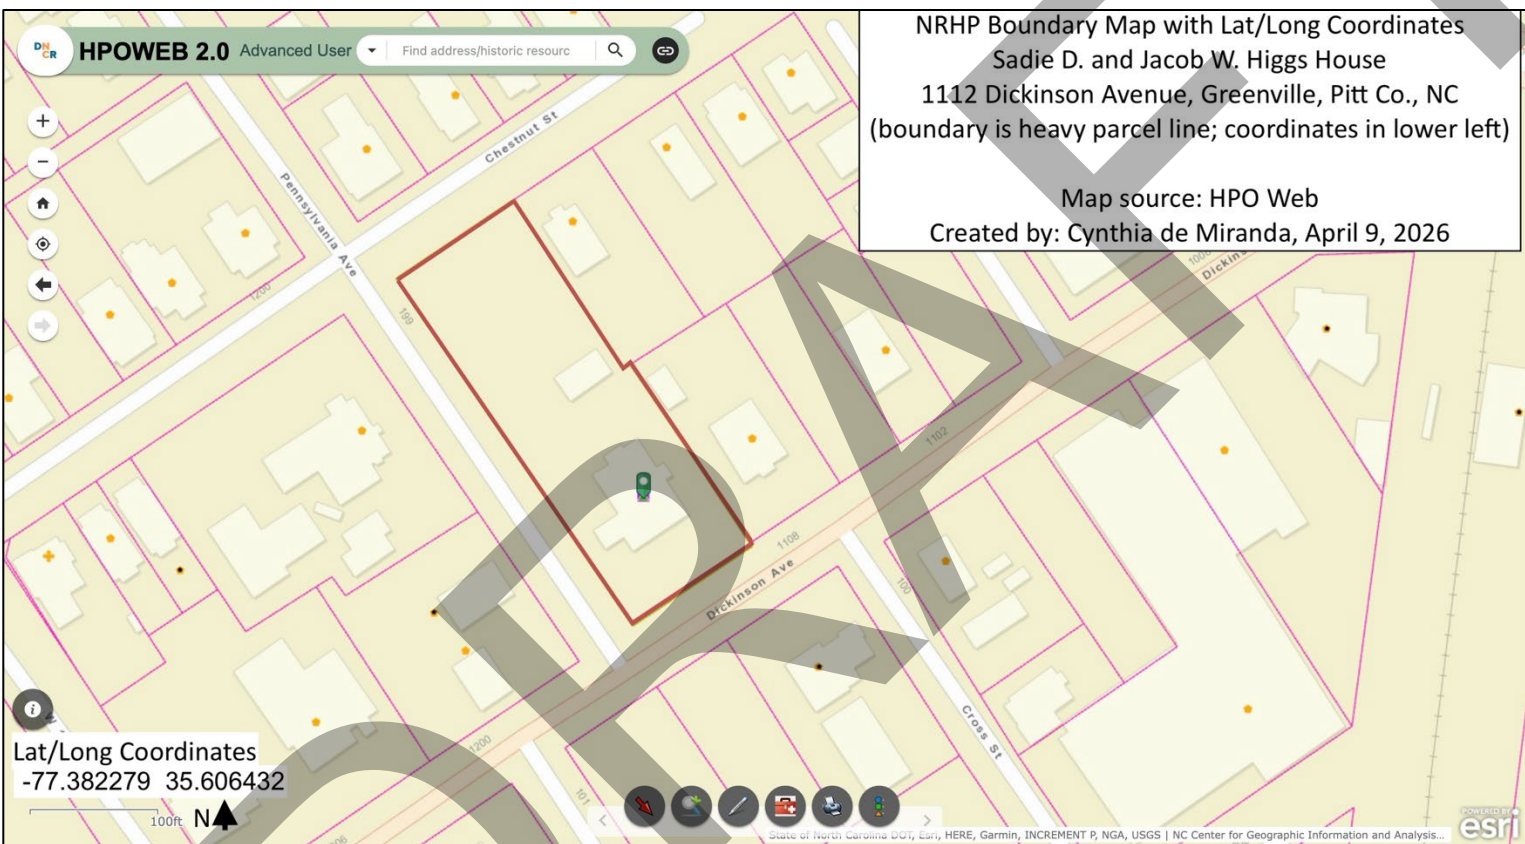


United States Department of the Interior
National Park Service

National Register of Historic Places
Continuation Sheet

Section number 10 Page 24

Higgs, Sadie D. and Jacob W., House
Name of Property
Pitt County, NC
County and State
Name of multiple listing (if applicable)

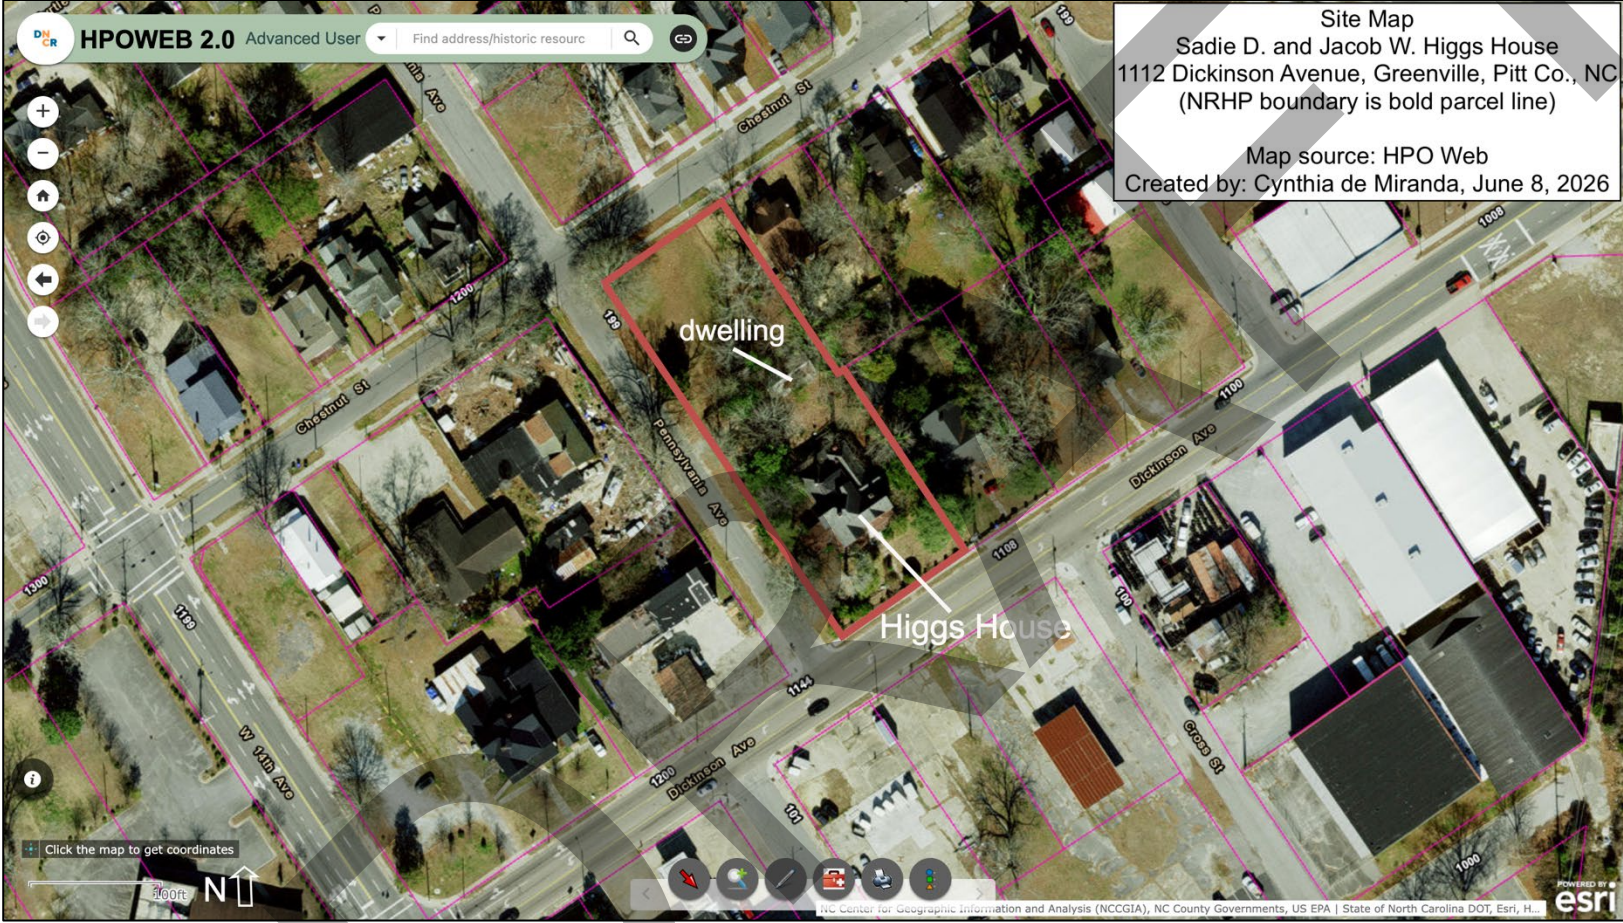

United States Department of the Interior
National Park Service

National Register of Historic Places
Continuation Sheet

Section number 10 Page 25


Higgs, Sadie D. and Jacob W., House
Name of Property
Pitt County, NC
County and State
Name of multiple listing (if applicable)



National Register of Historic Places Continuation Sheet

Section number 10 Page 26

Higgs, Sadie D. and Jacob W., House
Name of Property
Pitt County, NC
County and State
Name of multiple listing (if applicable)

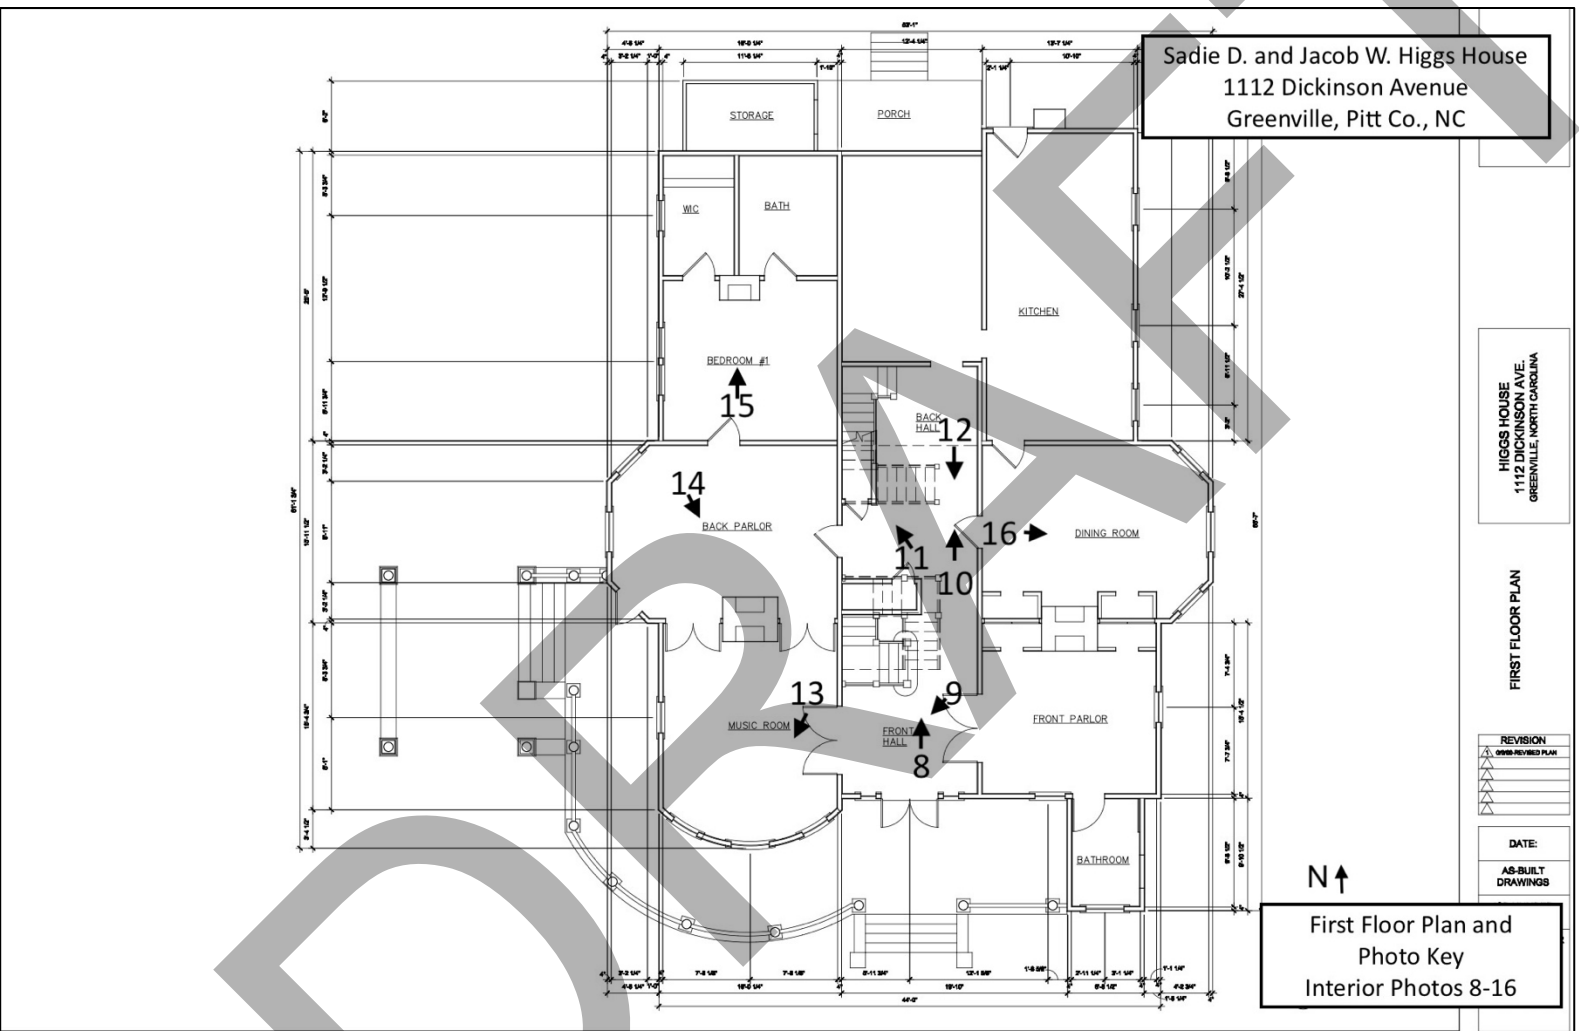

United States Department of the Interior
National Park Service

National Register of Historic Places
Continuation Sheet

Section number 10 Page 27

Higgs, Sadie D. and Jacob W., House
Name of Property
Pitt County, NC
County and State
Name of multiple listing (if applicable)

Sadie D. and Jacob W. Higgs House
1112 Dickinson Avenue
Greenville, Pitt Co., NC

HIGGS HOUSE
1112 DICKINSON AVE.
GREENVILLE, NORTH CAROLINA


SECOND FLOOR PLAN

REVISION
1. 0500-REVISED PLAN

DATE:

AS-BUILT
DRAWINGS

JOB NUMBER:
000000

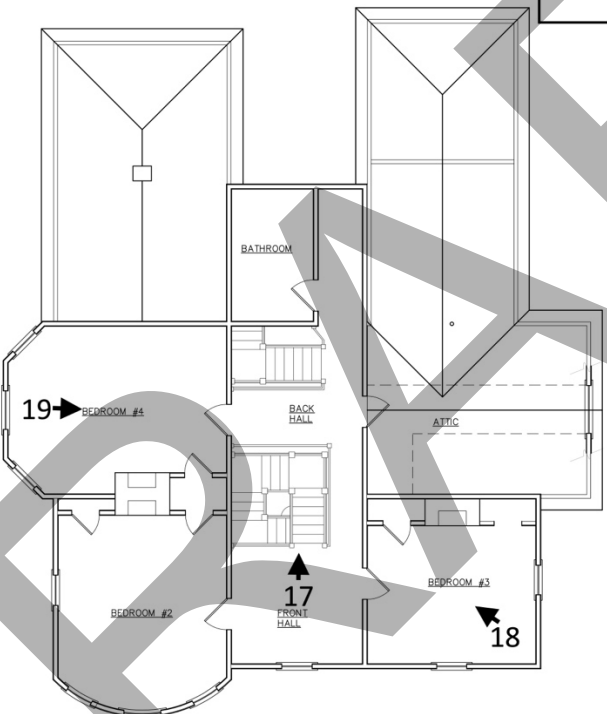

N ↑

Second Floor Plan and Photo Key
Interior Photos 17-19